




REAR ELEVATION

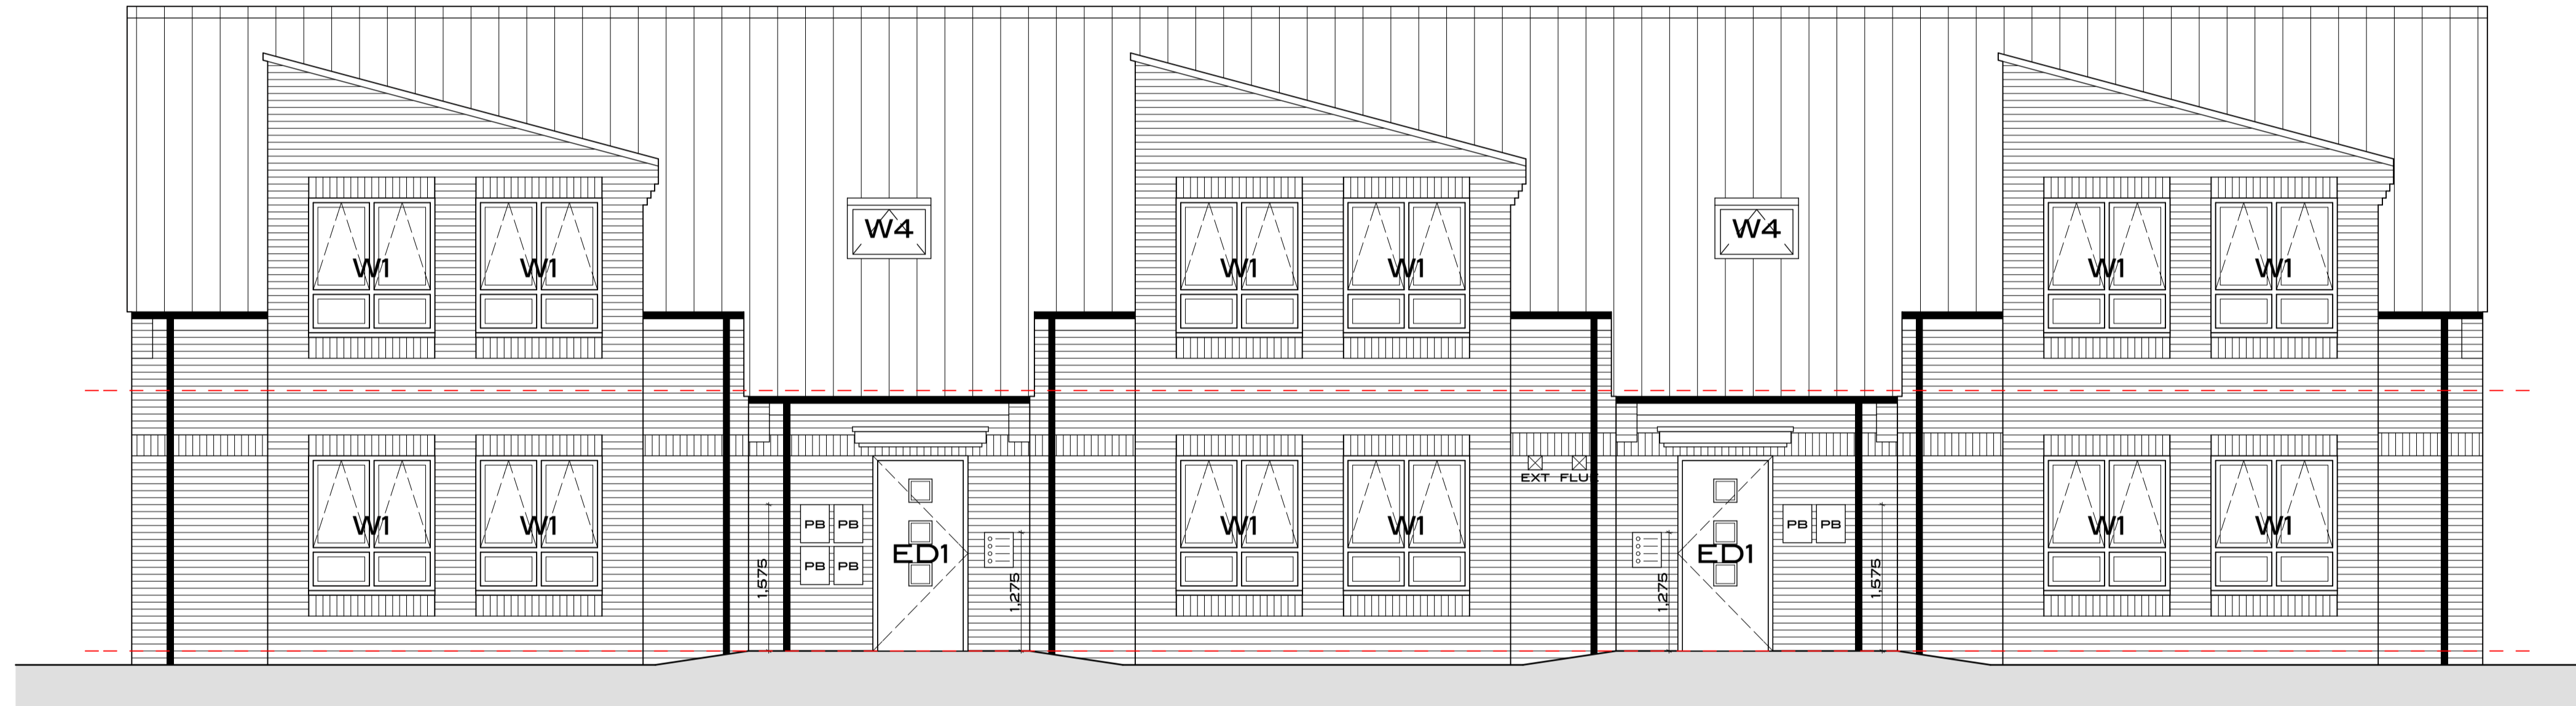

FRONT ELEVATION

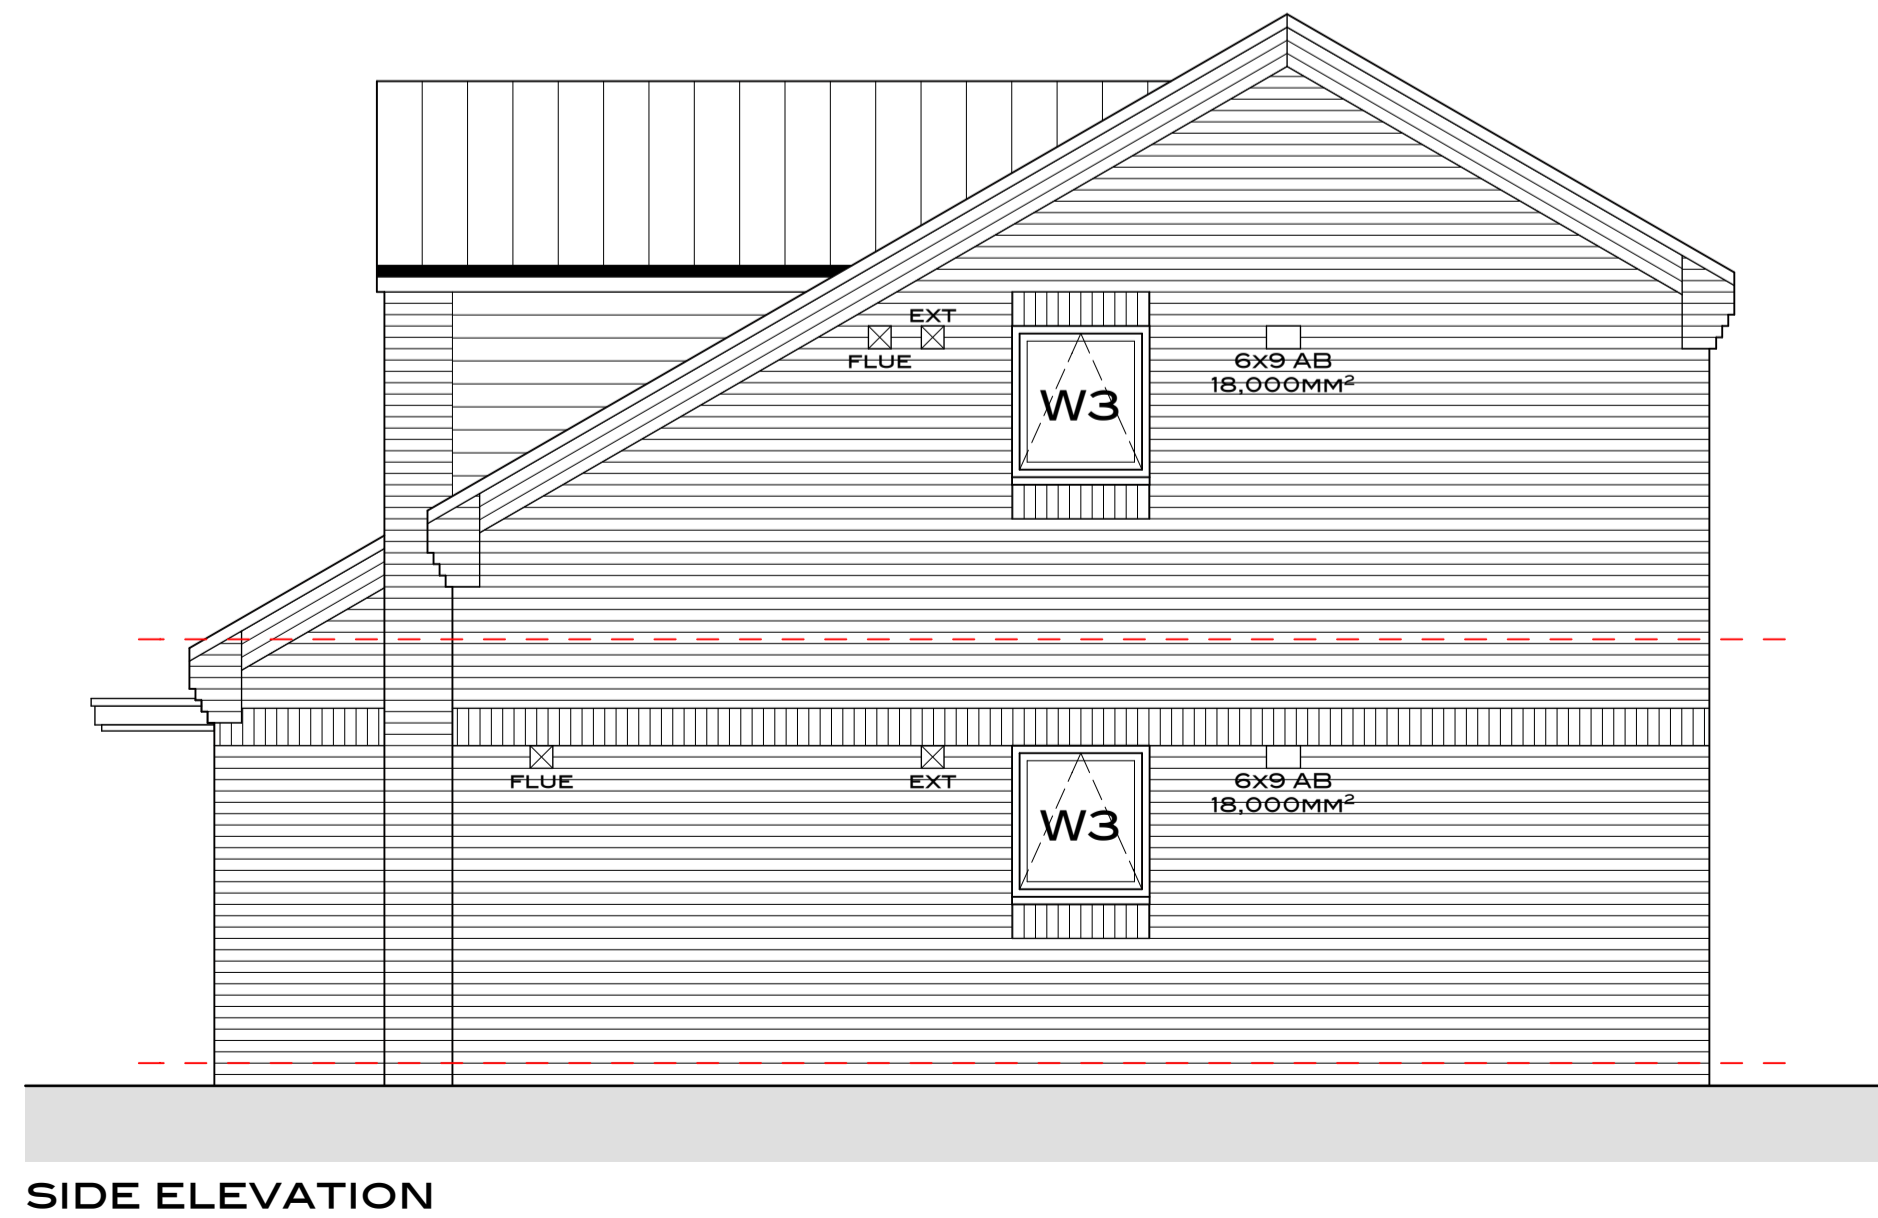


SIDE ELEVATION

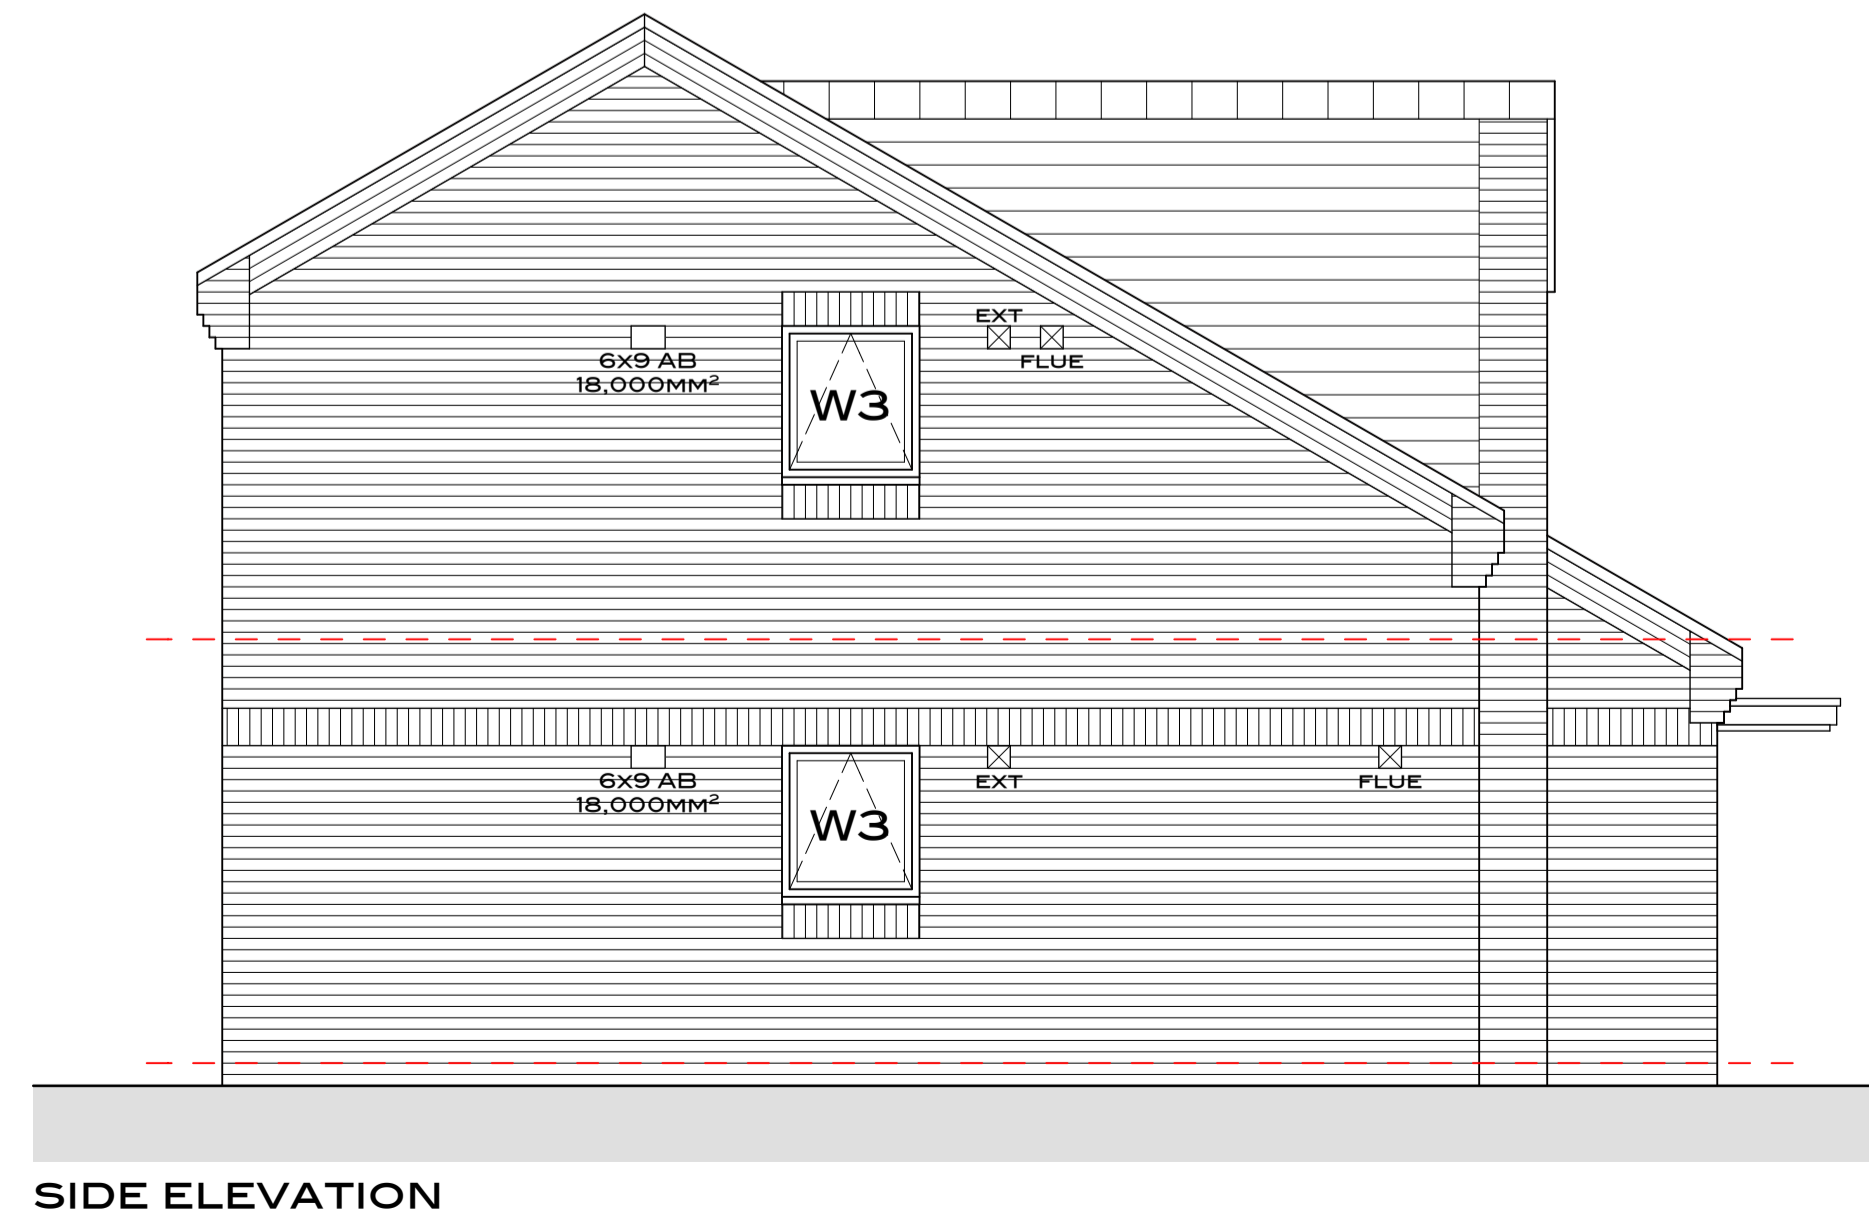

SIDE ELEVATION

****AS BUILT****

Rev A - 16.06.14 - Kitchen and bathroom extracts shown. Airbrick locations for additional ventilation shown.
 Rev B - 15.07.14 - Vertical tiling to side elevations.
 Rev C - 27.08.14 - Position of entrance doors amended.
 Rev D - 08.01.15 - Letterbox and door entry positions added.

	6no. Flats and 1no. Wheelchair Bungalow at Mill Lane, Grassmoor	
	Flats 1-6 - Elevations	
Scale : 1:50 @ A1	Date : 12.05.14	
Drwg. No. 1716/L05		Rev. D

DO NOT SCALE FROM THIS DRAWING