




PLOT 7
REAR ELEVATION

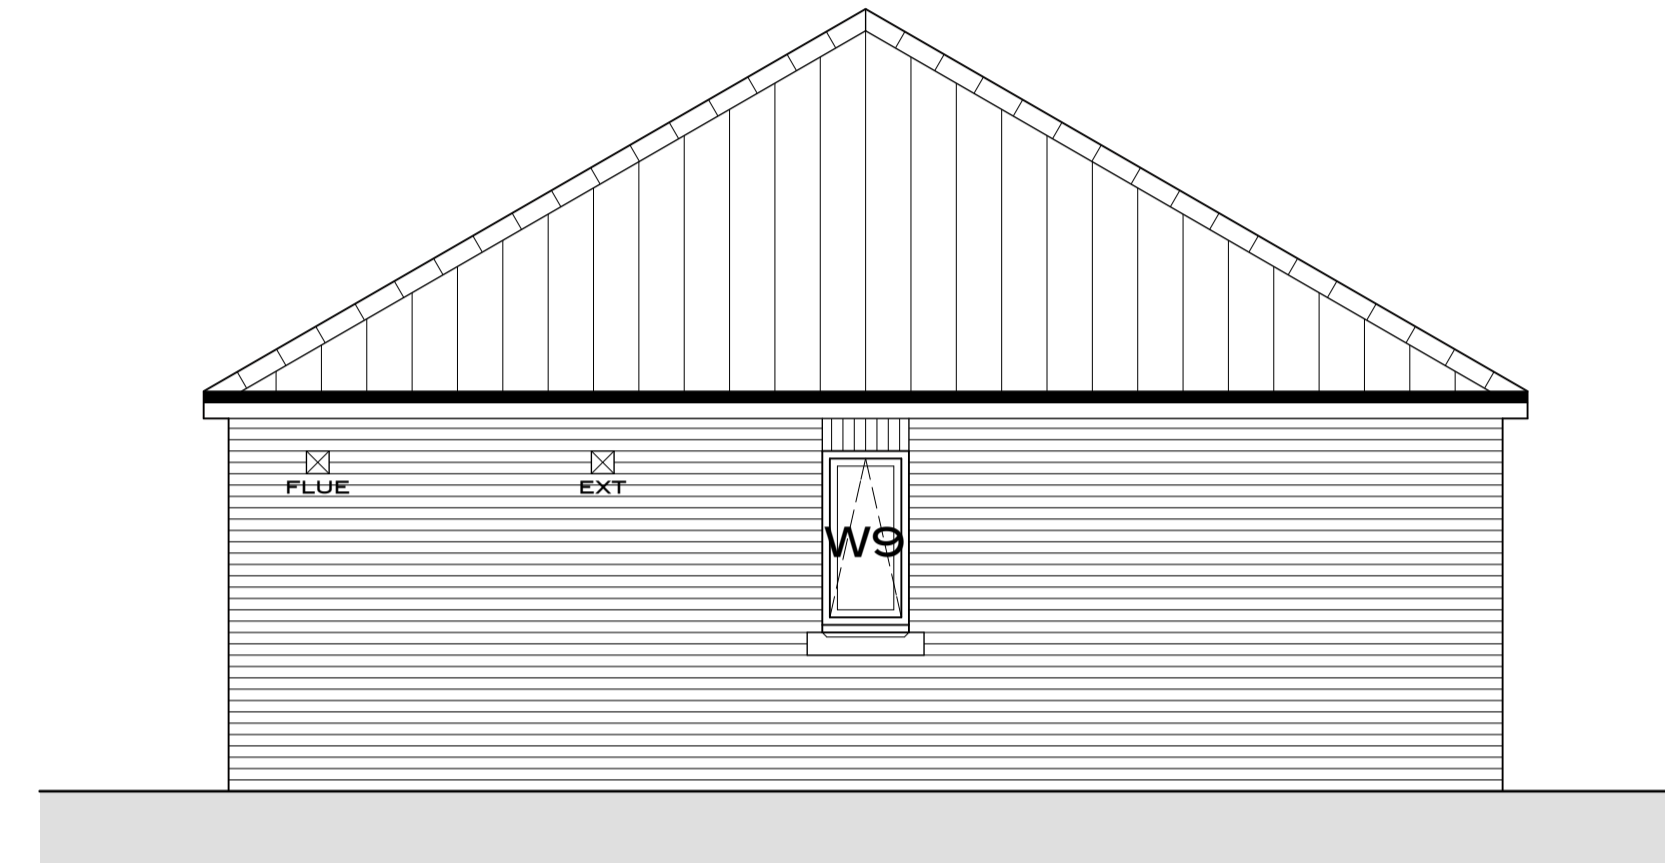

PLOT 7
SIDE ELEVATION

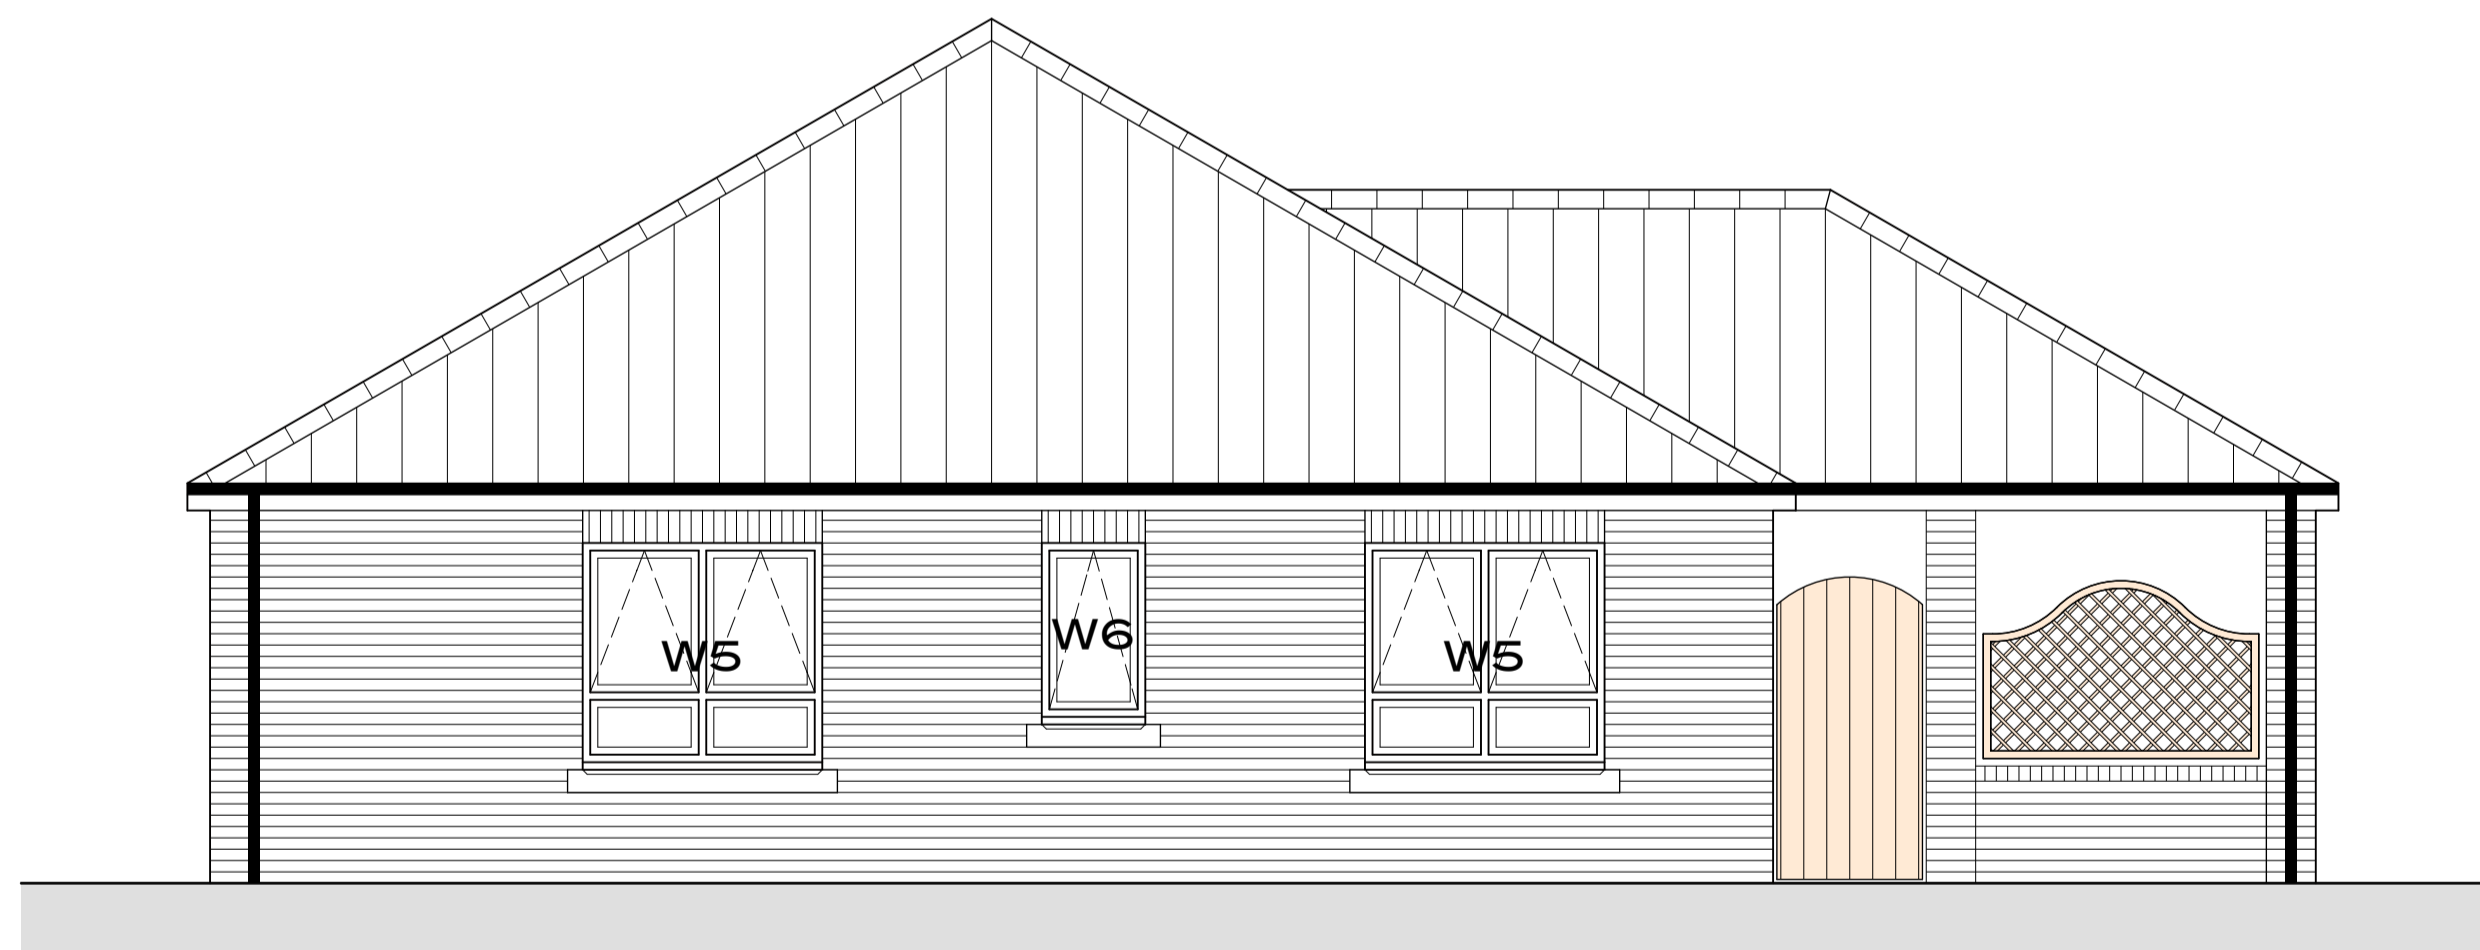

PLOT 7
FRONT ELEVATION

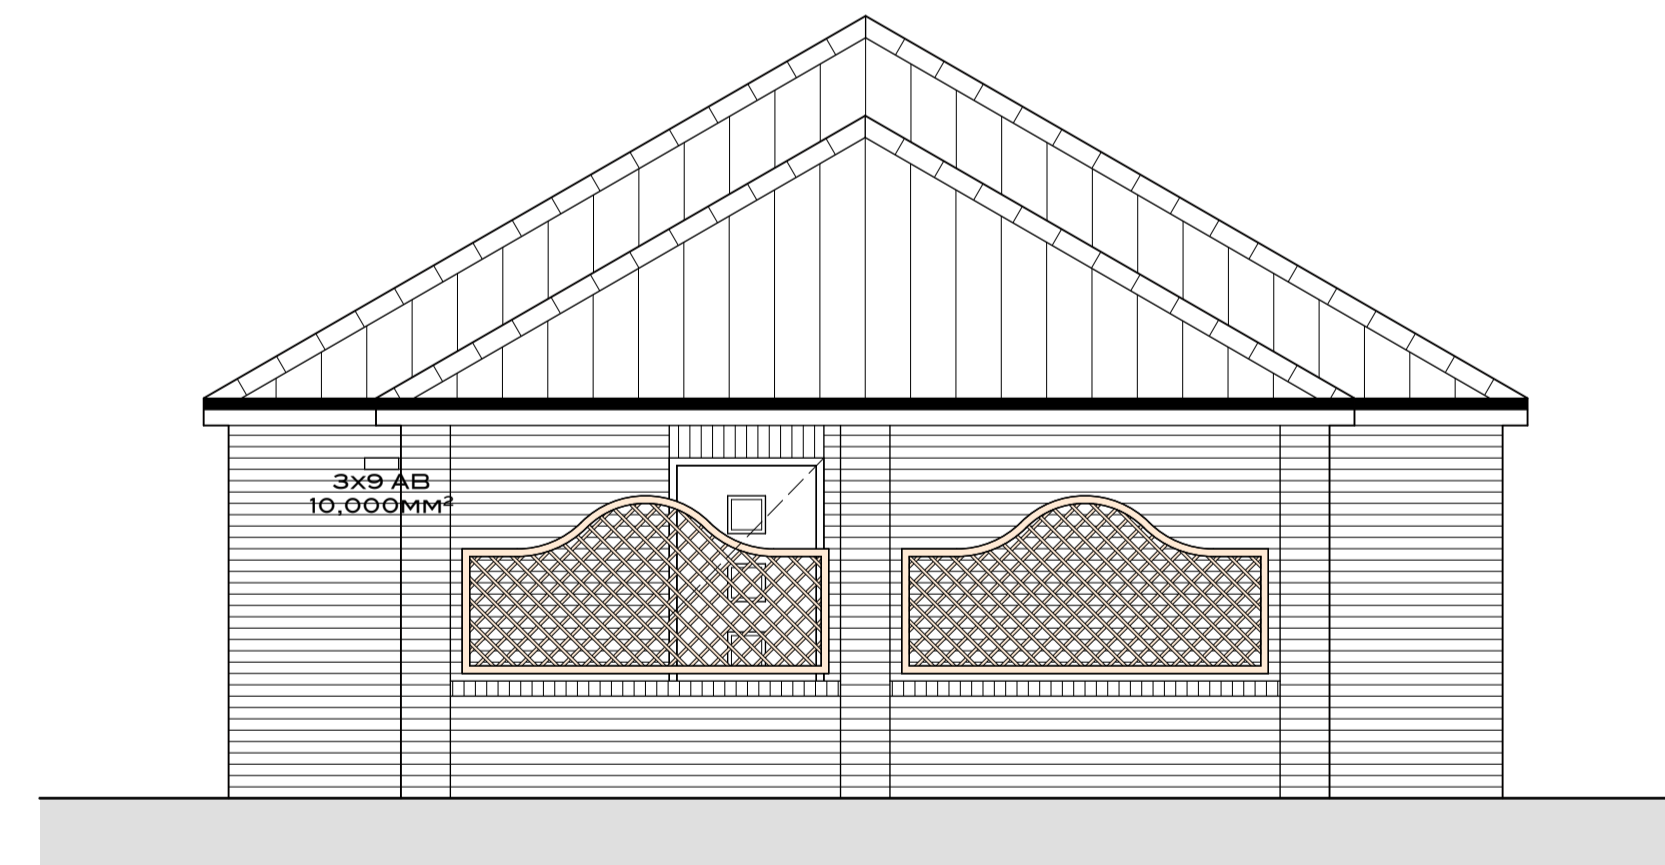

PLOT 7
SIDE ELEVATION

****AS BUILT****

Rev A - 16.06.14 - Kitchen and bathroom extracts shown. Airbrick locations for additional ventilation shown.

	6no. Flats and 1no. Wheelchair Bungalow at Mill Lane, Grassmoor
	2B3P Bungalow - Elevations
	Scale : 1:50 @ A1 Date : 12.05.14
Drwg. No. 1716/L07 Rev. A	

DO NOT SCALE FROM THIS DRAWING