


**PLOT 7  
ROOF PLAN**

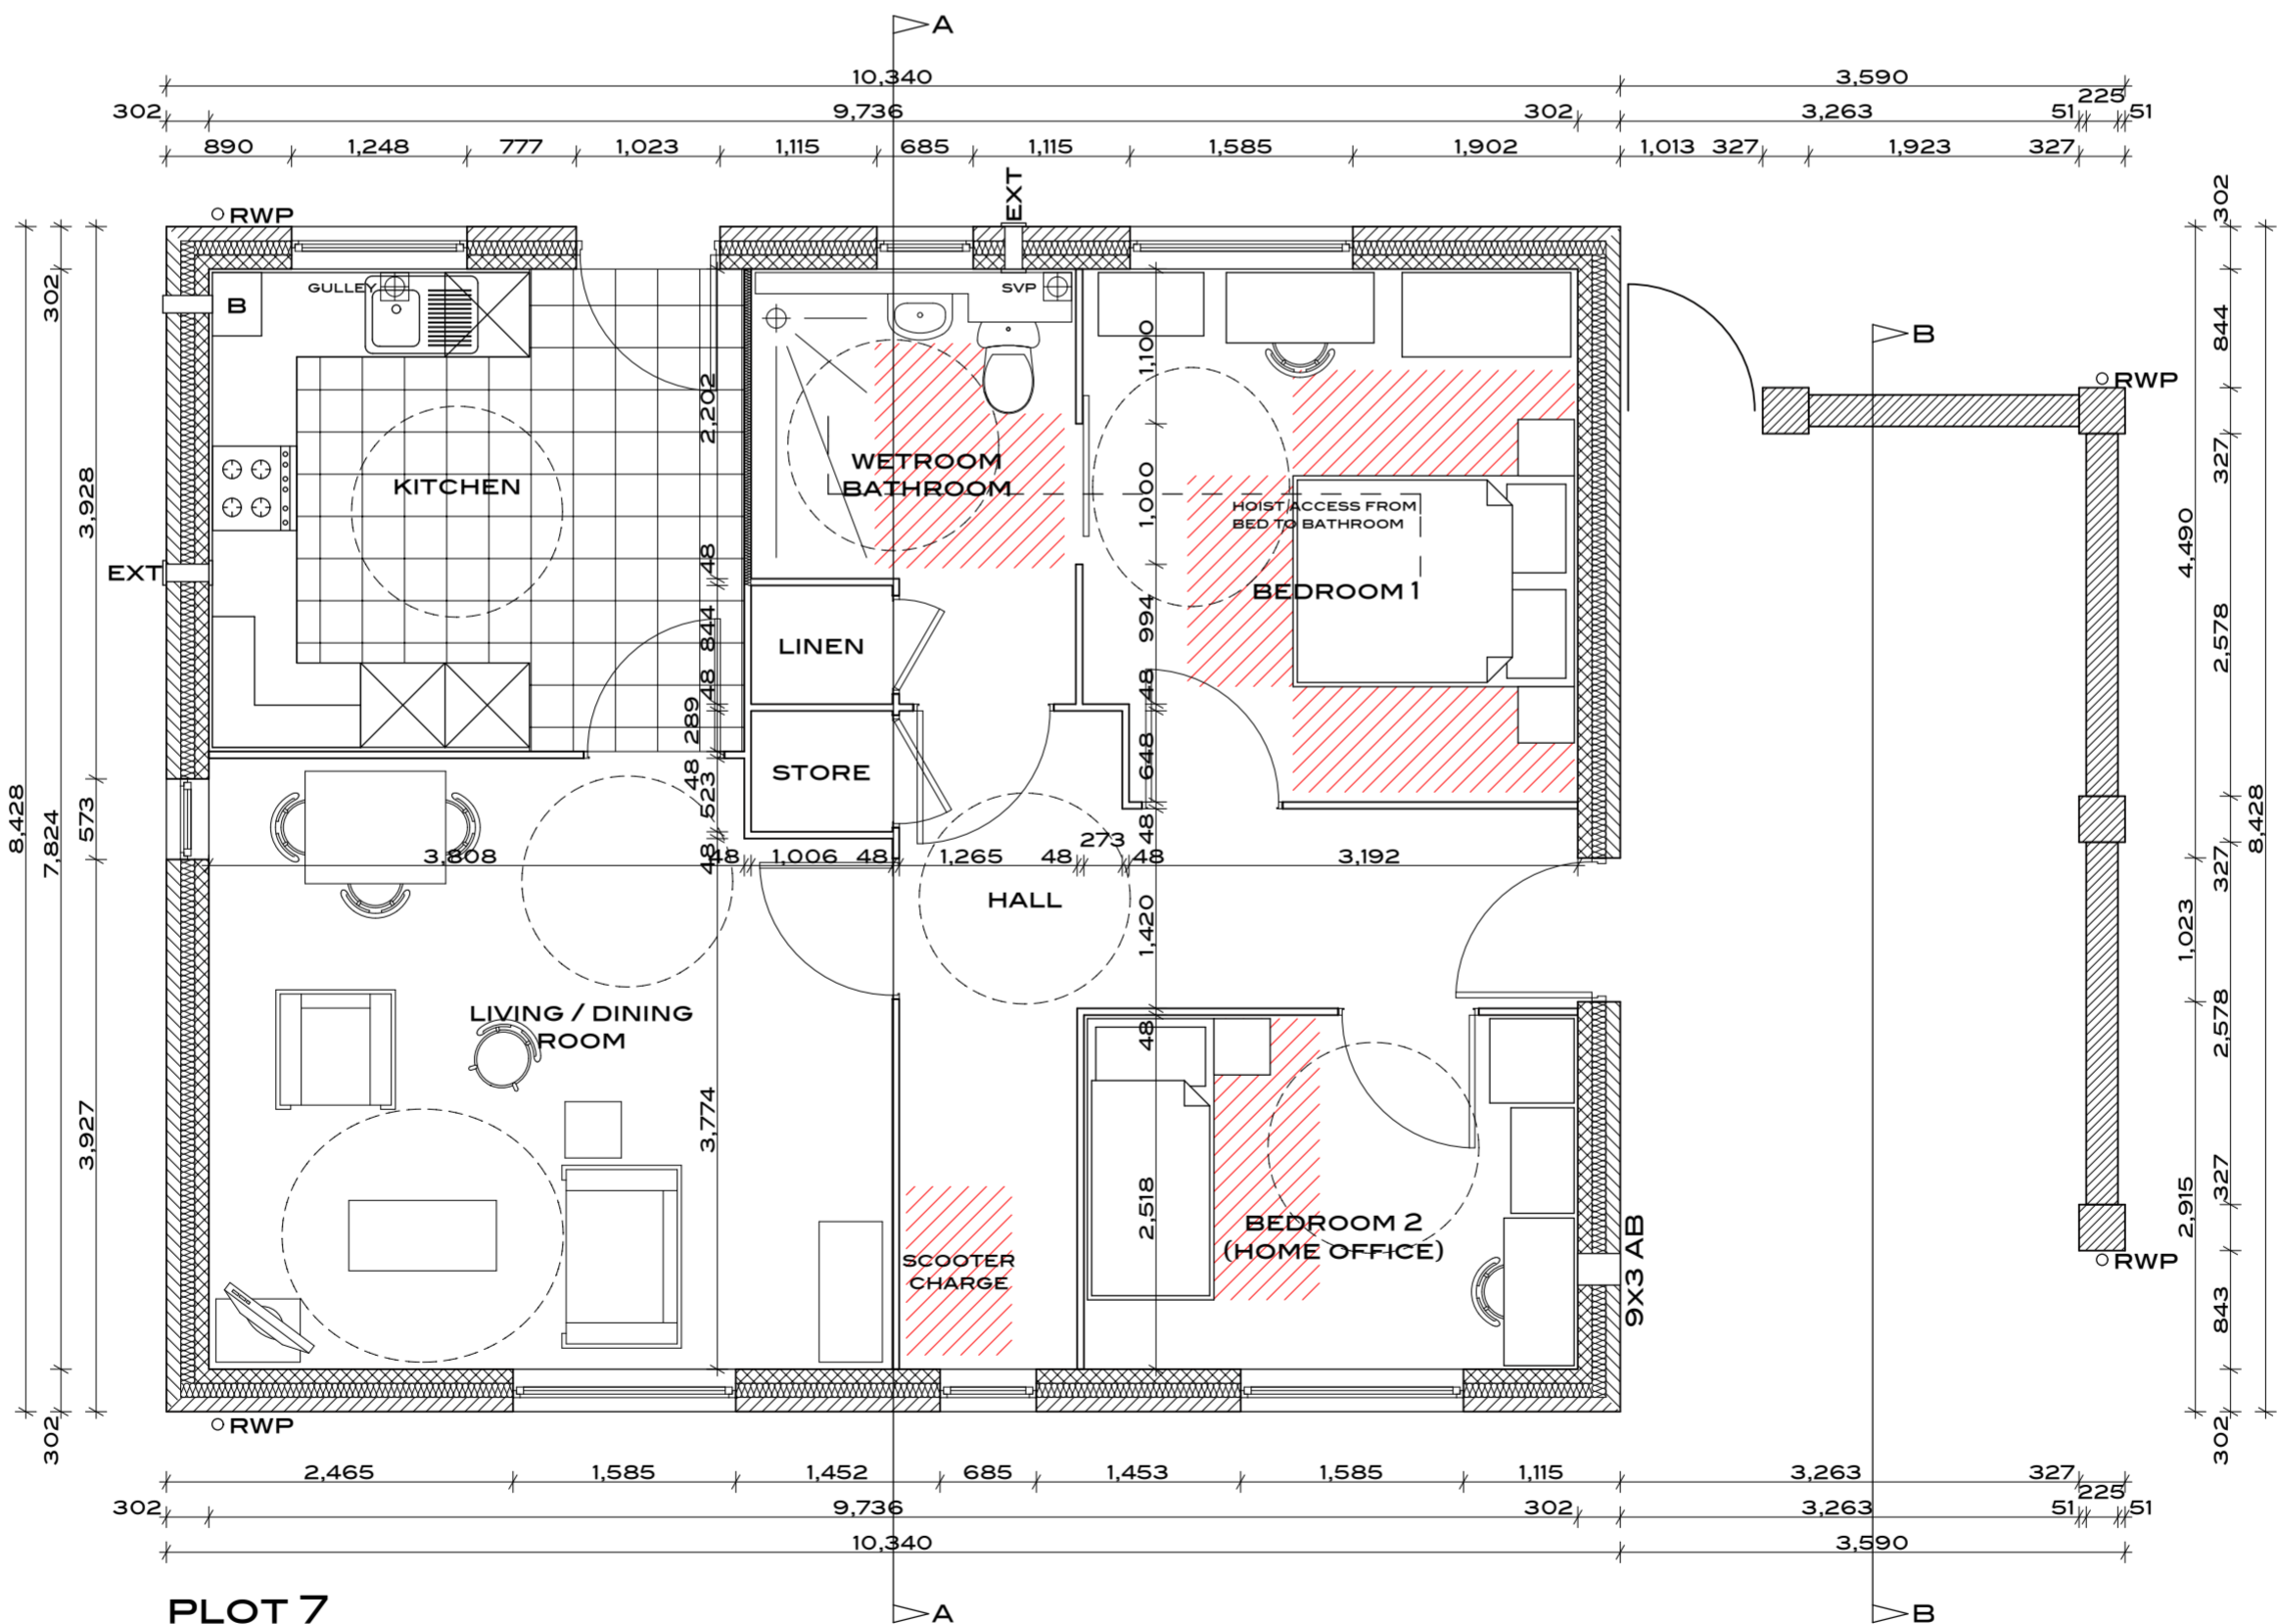

**PLOT 7  
GROUND FLOOR PLAN**

**\*\* AS BUILT \*\***

Rev A - 15.05.14 - Roof layout and references added.  
 Rev B - 16.06.14 - Kitchen and bathroom extracts shown. Airbrick locations for additional ventilation shown.  
 Rev C - 27.08.14 - External walls amended to 302mm brick and block.

	<b>6no. Flats and 1no. Wheelchair Bungalow at Mill Lane, Grassmoor</b>	
	<b>2B3P Bungalow - Floor Plan</b>	
Scale : 1:50 @ A2	Date : 17.04.14	
<b>Drwg. No. 1716/L02</b>		<b>Rev. C</b>

DO NOT SCALE FROM THIS DRAWING