



**PLOTS 1-6
FIRST FLOOR PLAN**

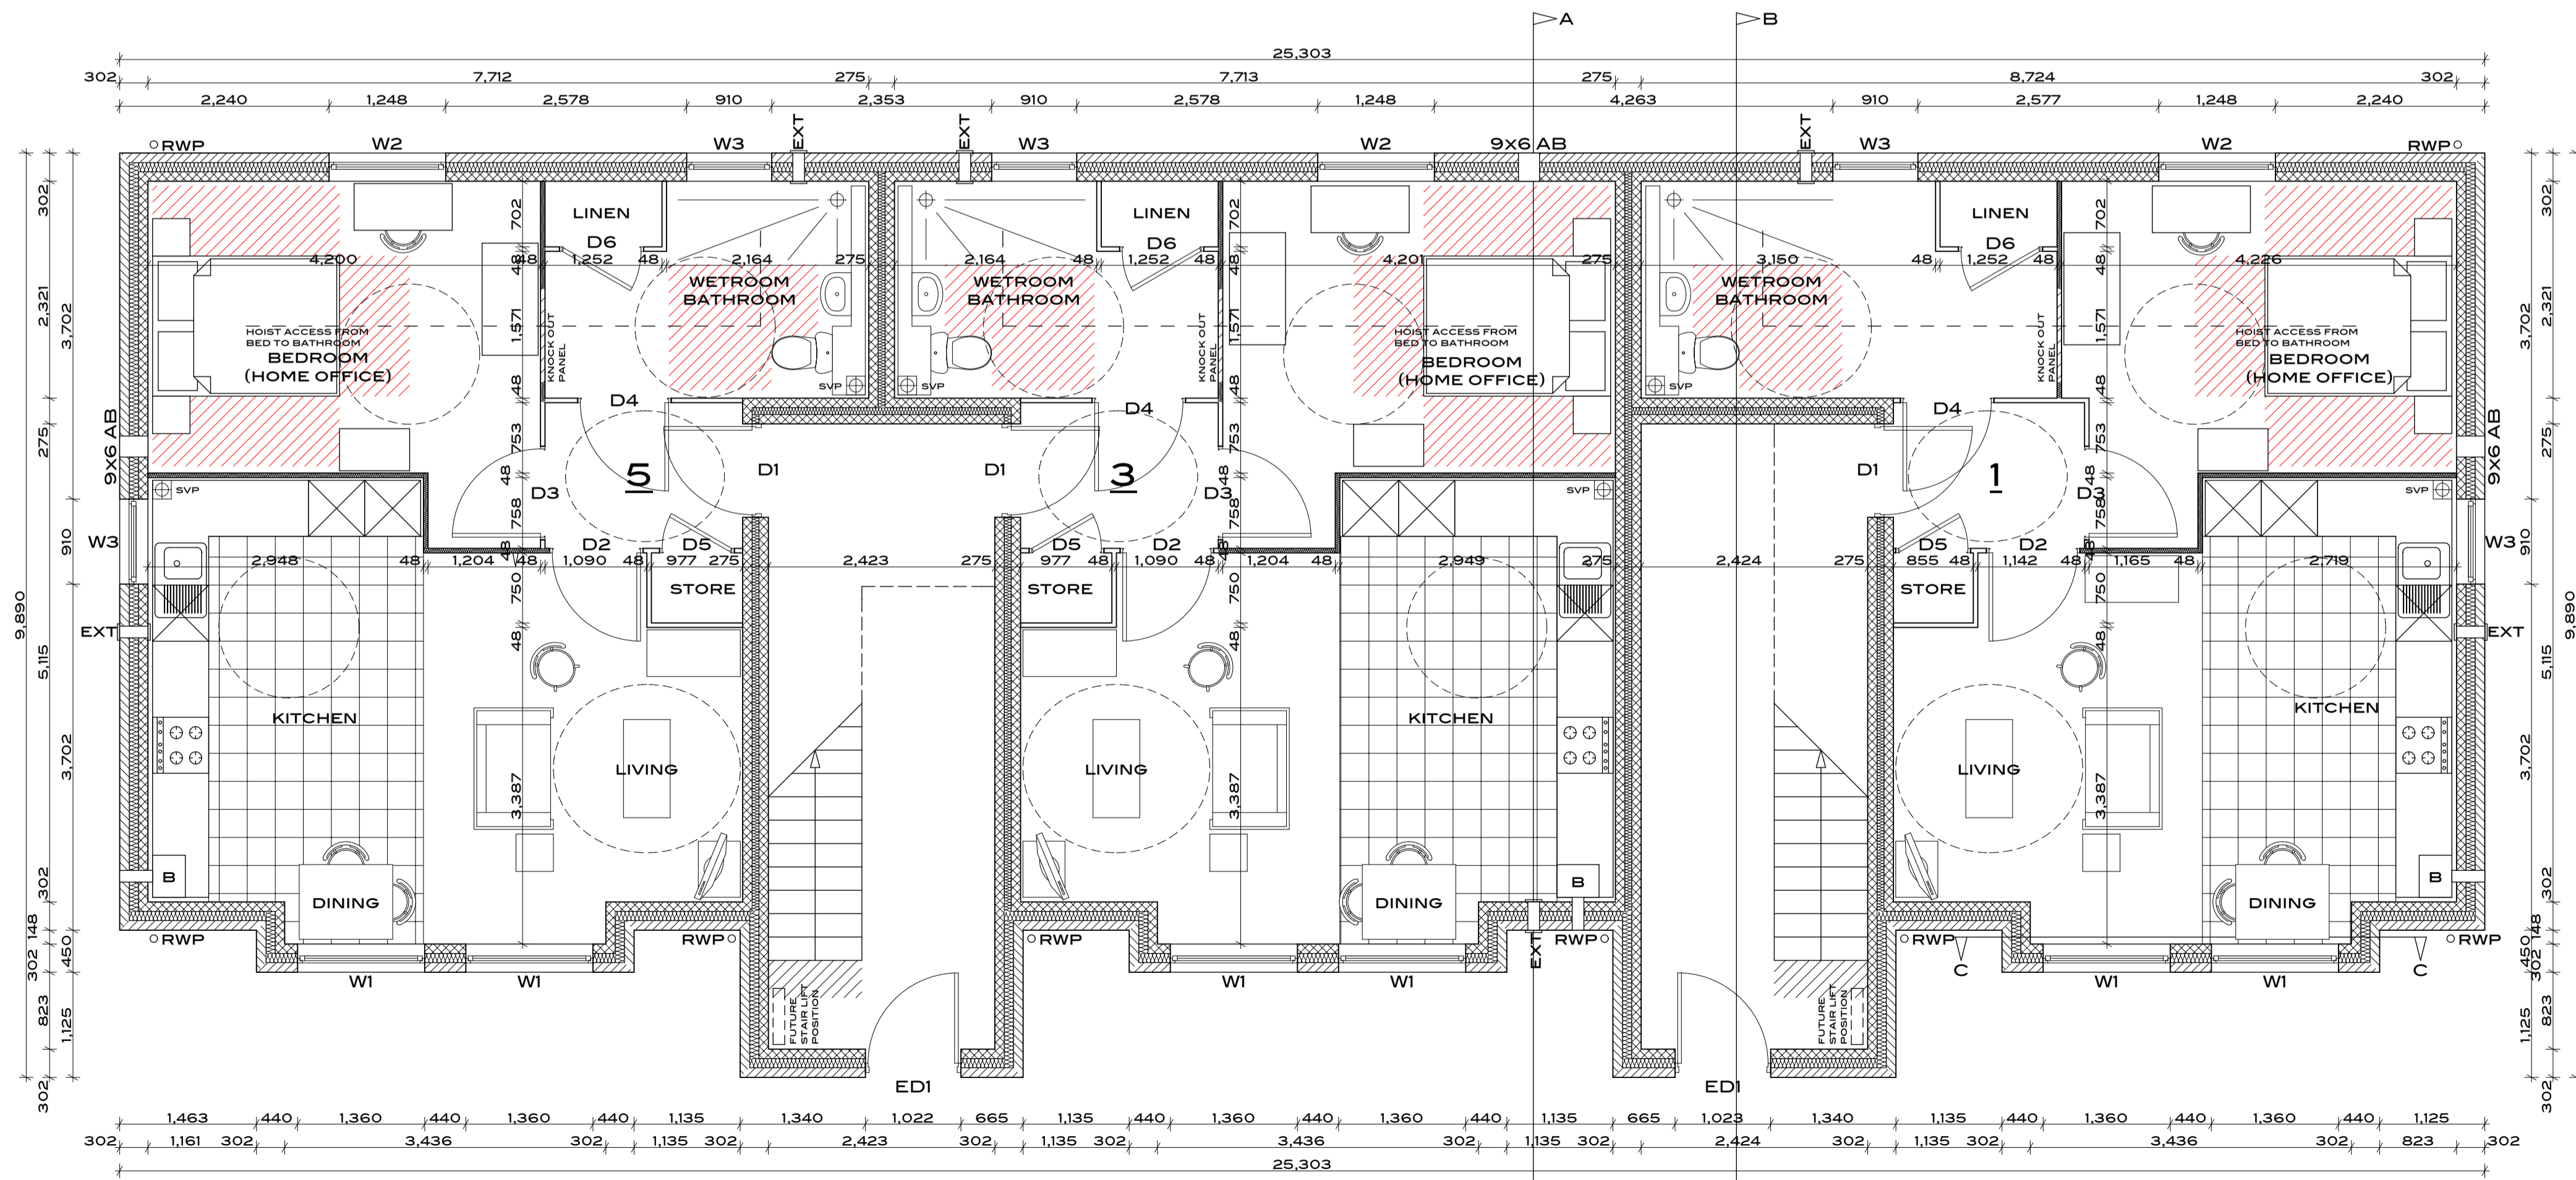

**PLOTS 1-6
GROUND FLOOR PLAN**

****AS BUILT****

- Rev A - 15.05.14 - References added.
- Rev B - 16.06.14 - Entrance doors set out correctly and 400mm zone at foot of stairs shown. Kitchen and bathroom extracts shown. Airbrick locations for additional ventilation shown.
- Rev C - 27.08.14 - External walls amended to 302mm brick and block.
- Rev D - 06.11.14 - Extent of kitchen floor finishes added.
- Rev E - 07.11.14 - Further amendments to kitchen floor finishes.

	6no. Flats and 1no. Wheelchair Bungalow at Mill Lane, Grassmoor	
	Flats 1-6 - Floor Plans	
	Scale: 1:50 @ A1	Date: 17.04.14
Dwg. No. 1716/L03 Rev. E		

DO NOT SCALE FROM THIS DRAWING