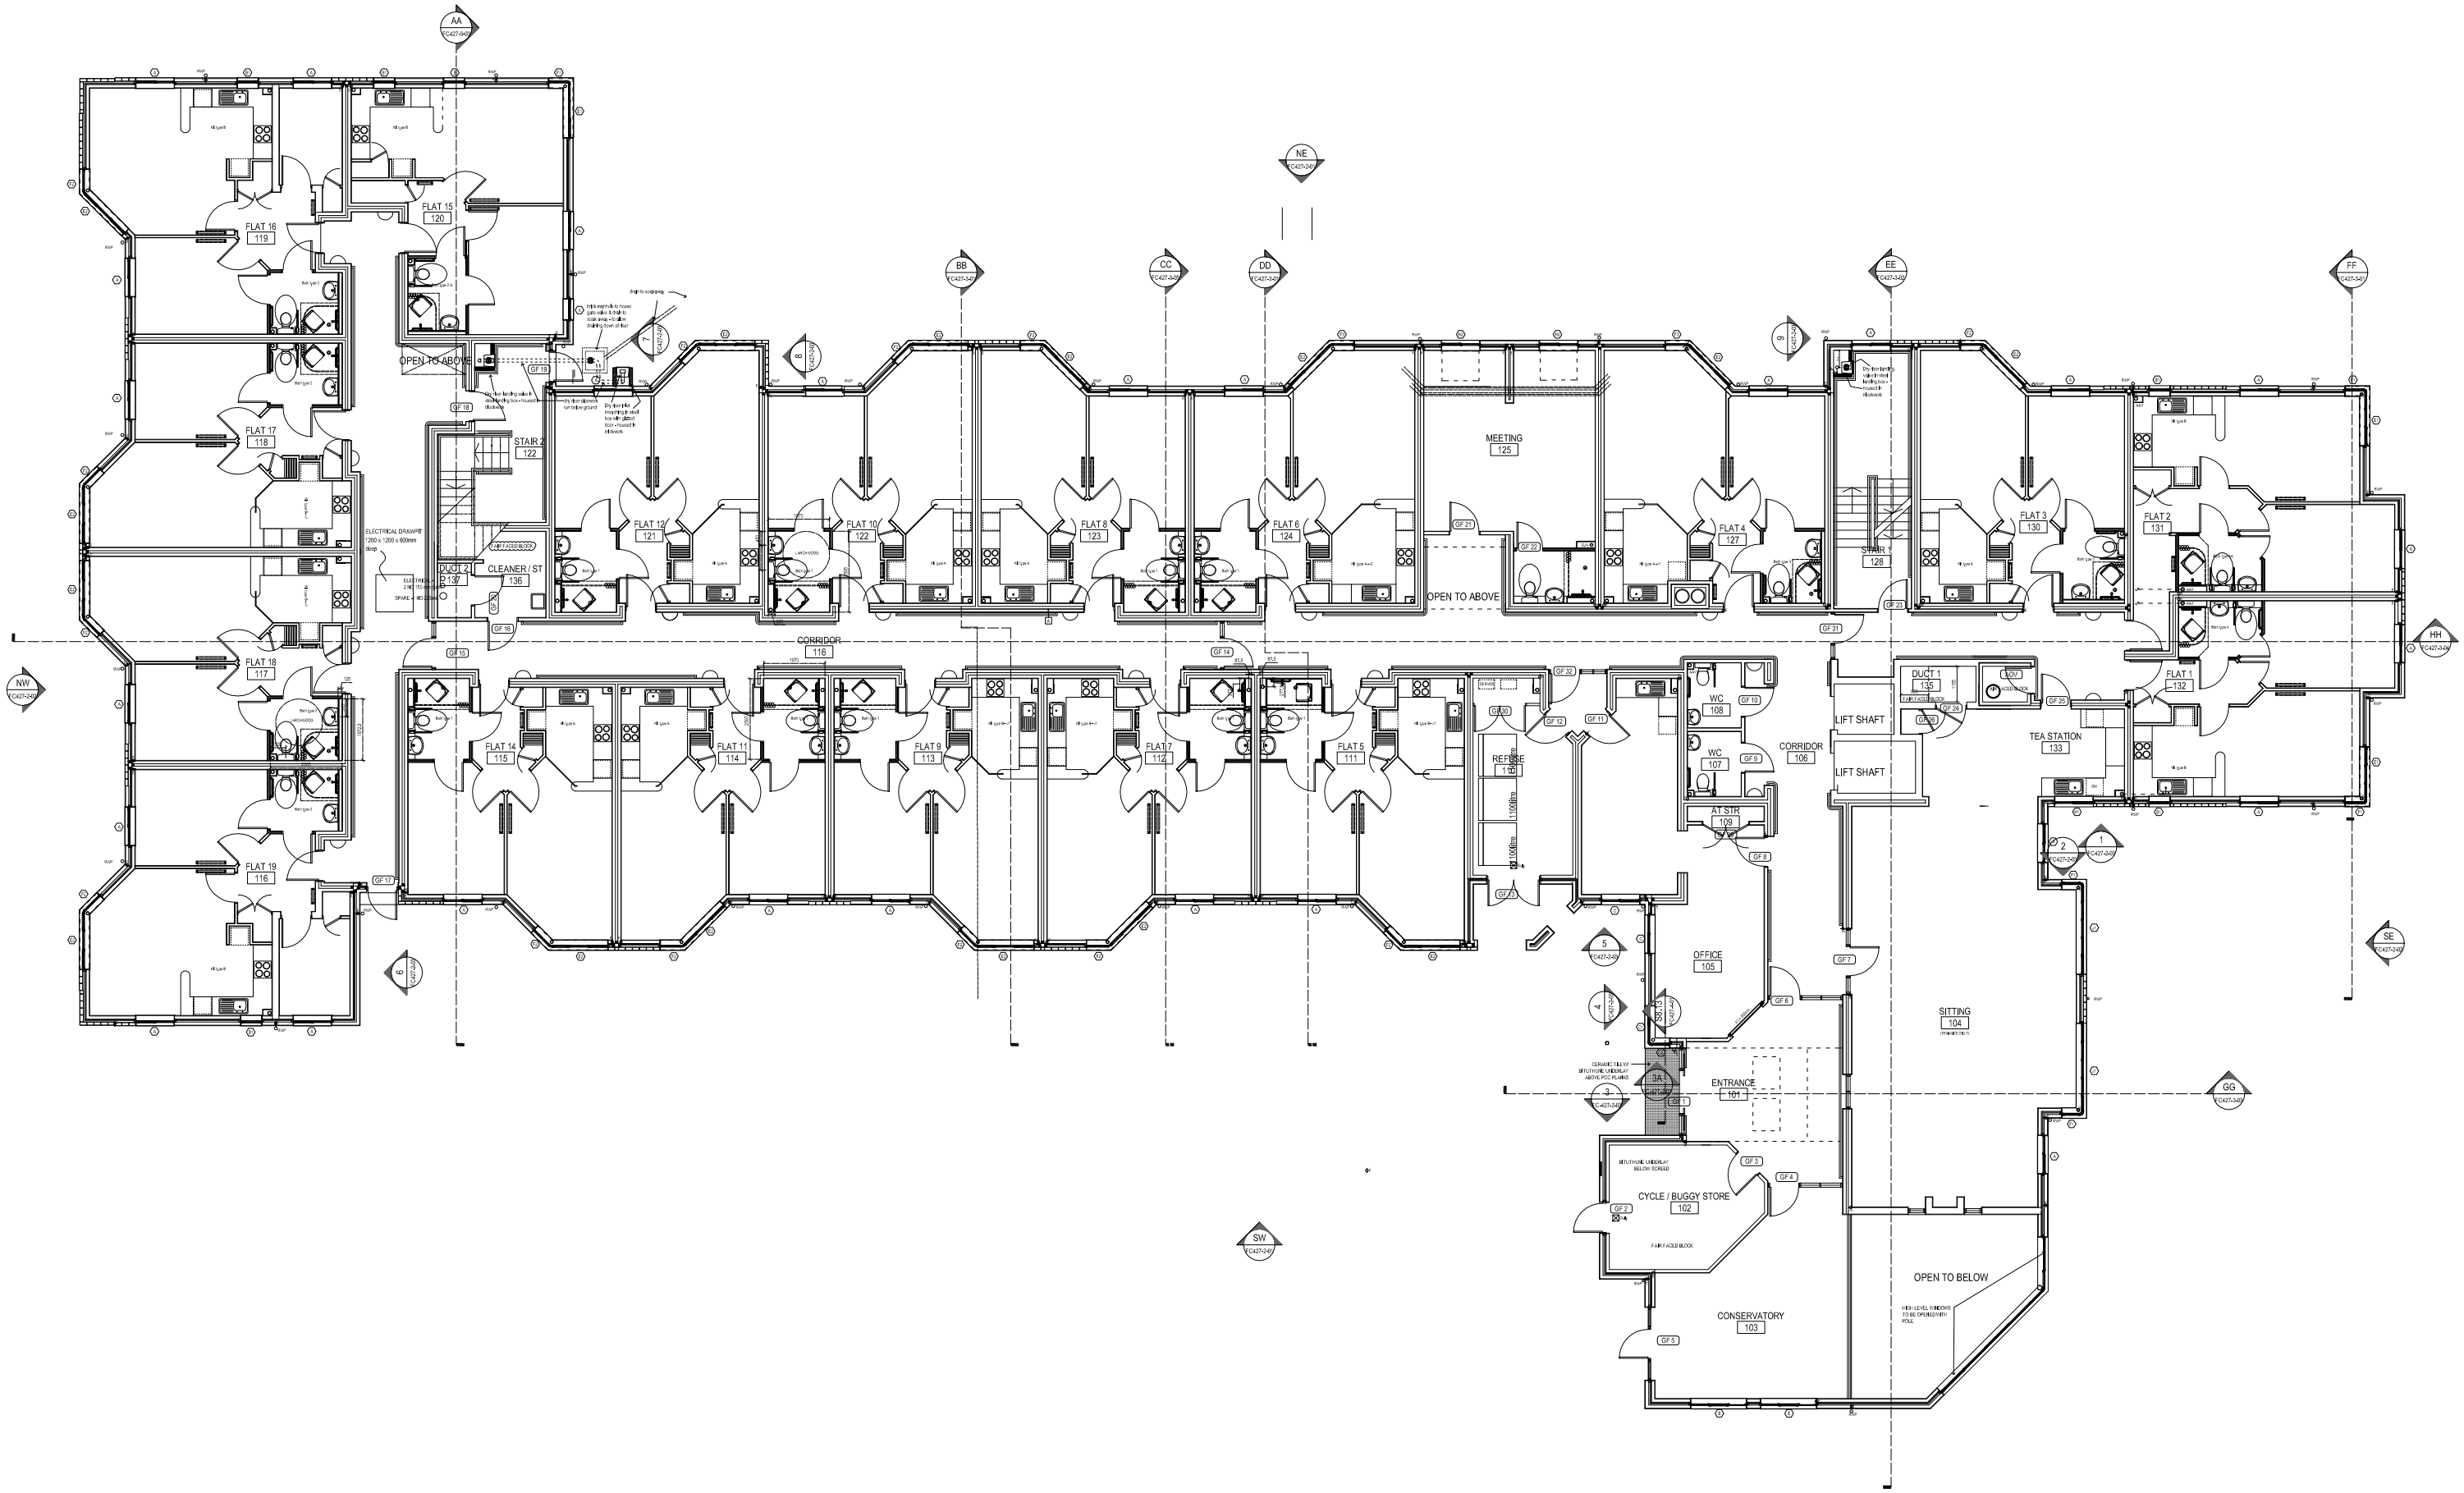

INTERNAL PARTITIONS

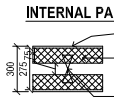

INTERNAL MASONRY SEPARATING WALL ROBUST DETAIL E-WM-2

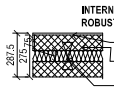

INTERNAL INSULATED MASONRY SEPARATING WALL

STUD WORK PARTITION

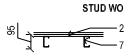

STUD WORK PARTITION

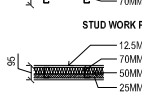

STUD WORK PARTITION IN FLAT TOILETS

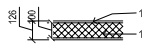

100 MM MASONRY PARTITION

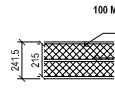

215 MM MASONRY PARTITION

MASONRY PARTITION AS ABOVE, PLASTER ONE SIDE

MASONRY PARTITION AS ABOVE, NO PLASTER

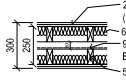

TIMBER SEPARATING WALL ROBUST DETAIL E-WT-1

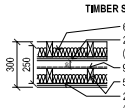

TIMBER SEPARATING WALL TO ROOF VOIDS

Rev C7: 28-09-05 - Dry riser added
Rev C6: 15-09-05 - Bathroom door handing
Rev C5: 27-06-05 - AOV added adjacent to kitchen extract
AOV added outside stair 2
Rev C4: 06-05-05 - Door GF24 relocated
Gullies added to bin / buggy sts
Door to Duct 1 relocated
Tea Station/Storage modified
Screen 'GF32' added
Rev C3: 13-04-05 - screen GF31 added
Position of lift doors modified to meet suppliers spec
Window type 'B1' added
Sitting room storage removed
Rev C2: 22-03-05 - Electric draw pit added adj stair 2
Gullies added to bin / buggy sts
Dimensions moved to dwg 1-07
Rev C1: 28-02-05 Building Regulations Application

Archadia Chartered Architects
Architecture : Surveying : Interiors : Space Planning : Design
ASHLEY HOUSE, 58-60 ASHLEY RD, HAMPTON, MIDDX, TW12 2HU. Tel: 020 89 415161 Fax: 020 89 415050

RECORD DRAWING

Project: Larchwood
Waldron Avenue, Coldean
Brighton BN1 9EZ

Title: Upper Ground Floor Plan

Client: Feltham Construction for
Hanover Housing Association

Scale: 1:100@A1, 1:200@A3 *Date:* 7-01-05
Drwg No: FC427-1-02 *Rev:* C7
File ref: *Rev Date:* 28-09-05