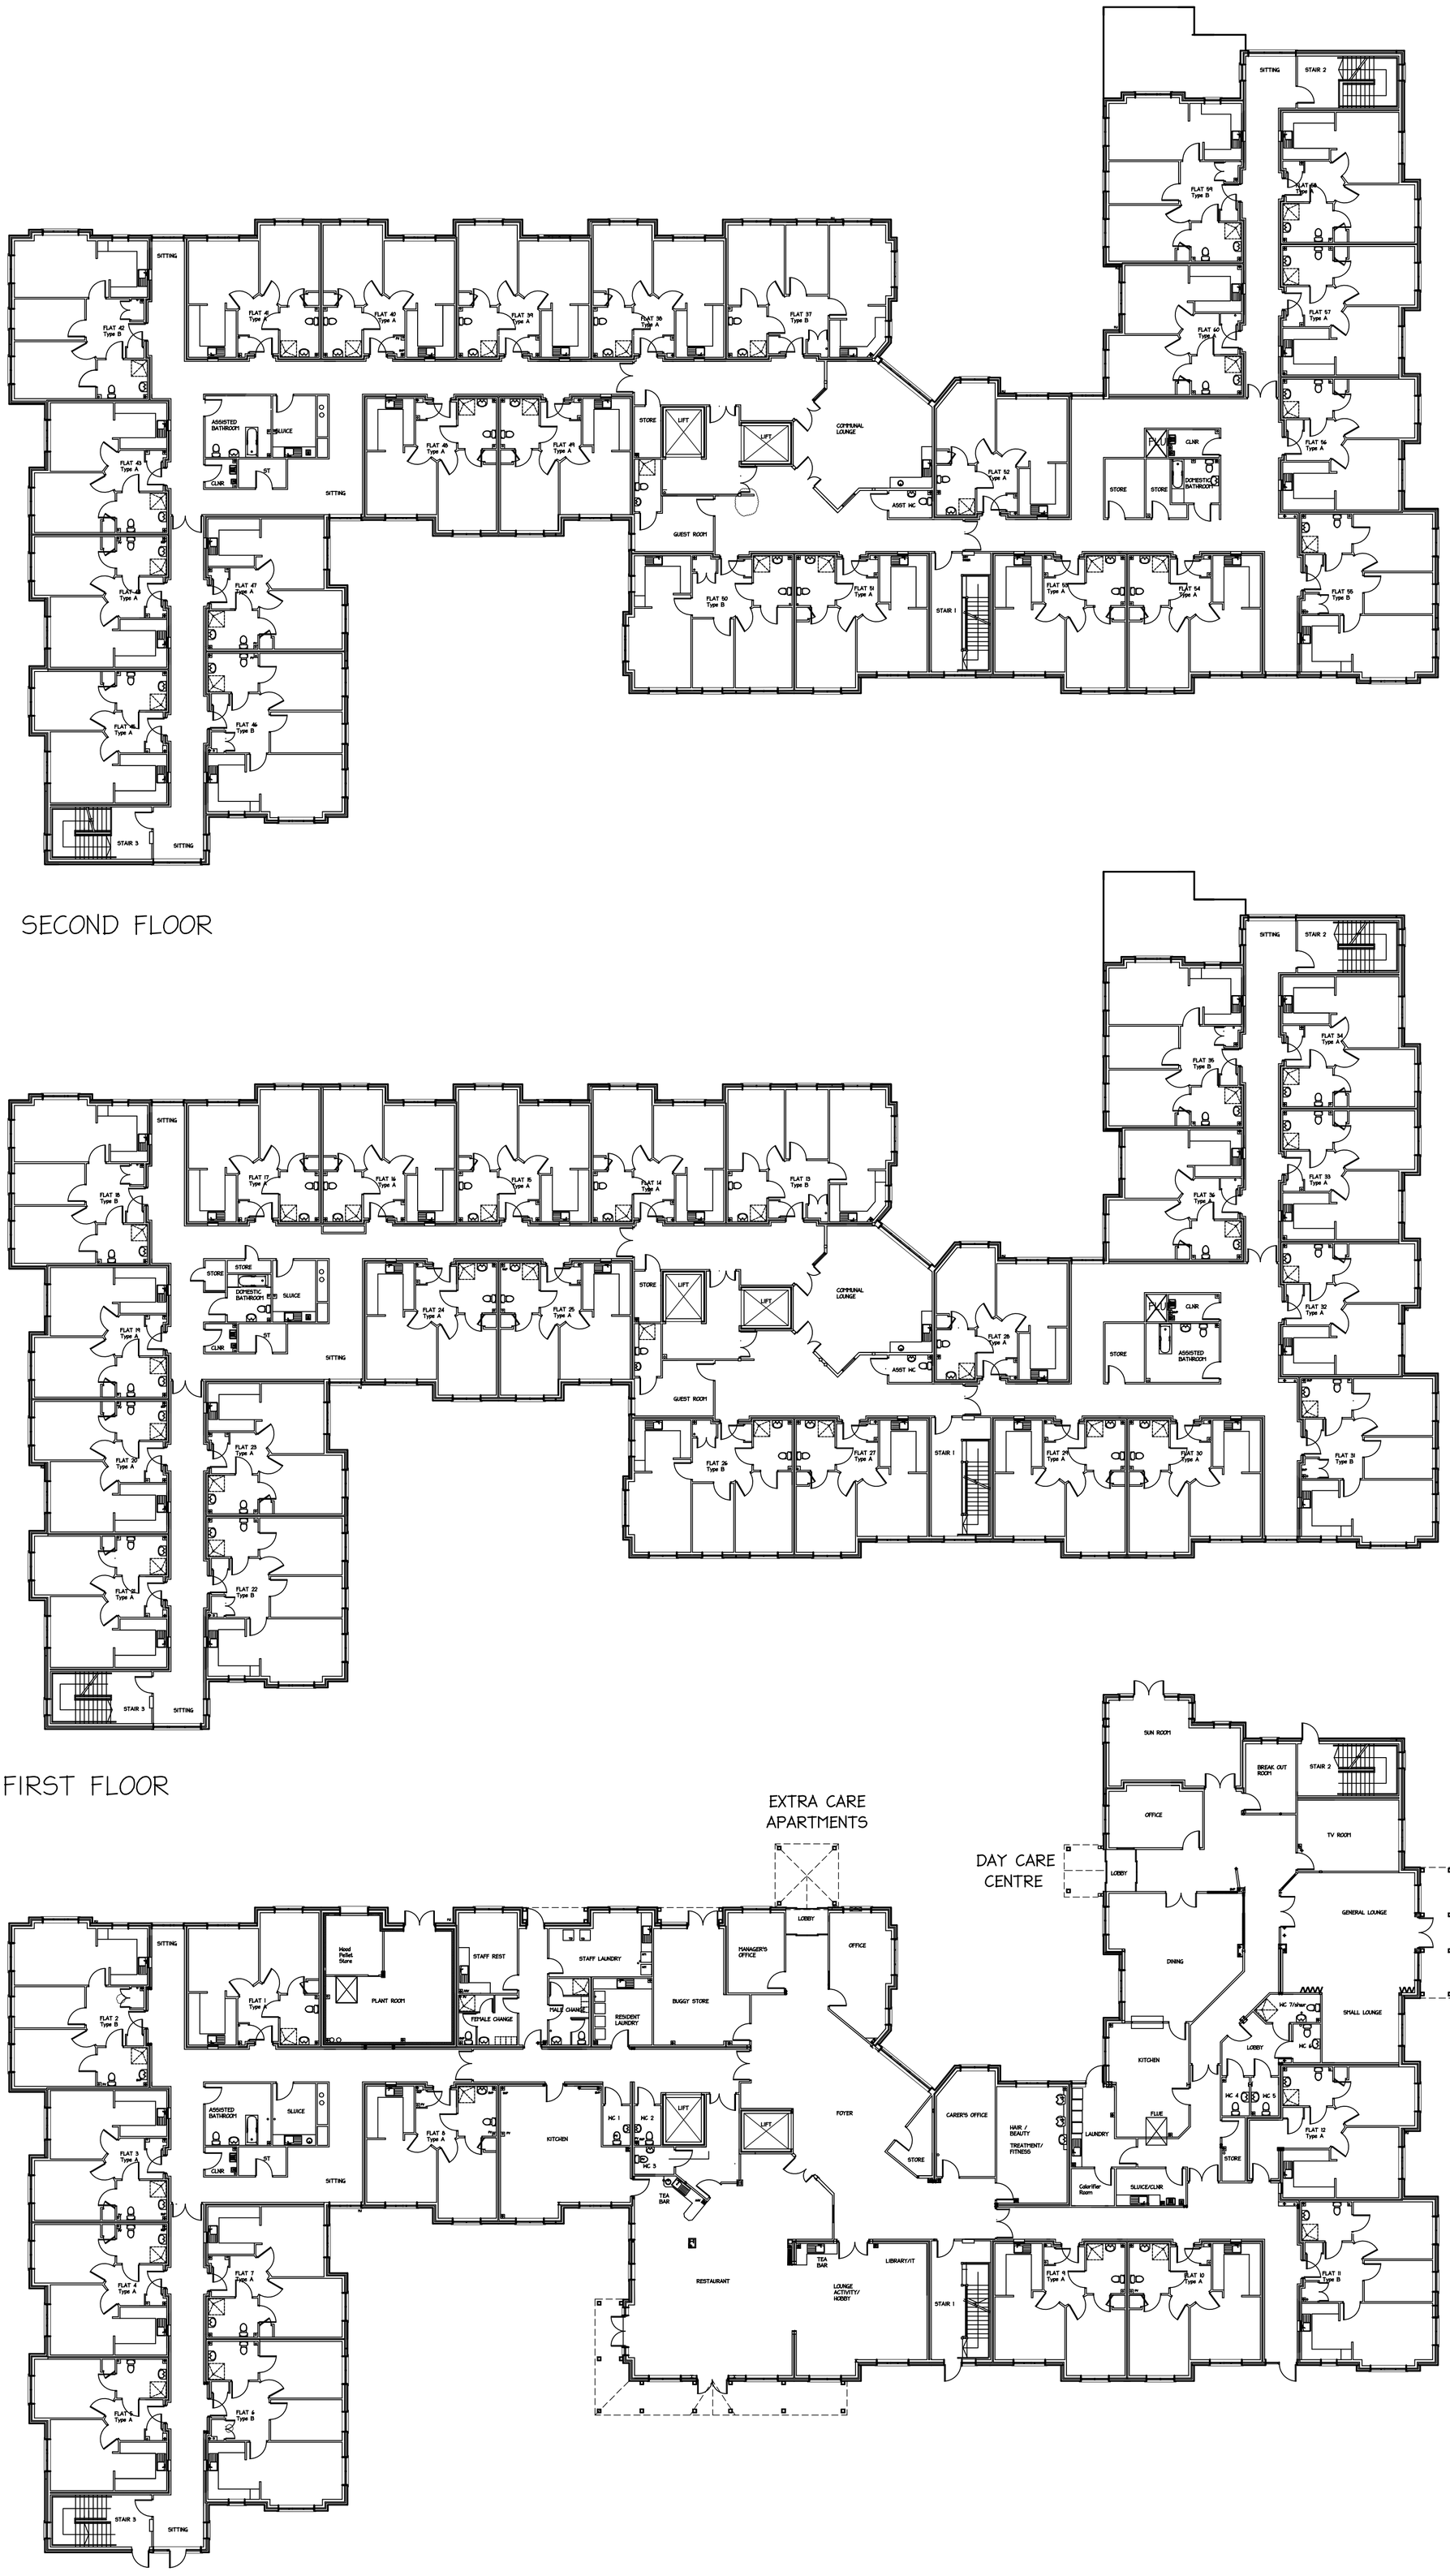

SECOND FLOOR

FIRST FLOOR

GROUND FLOOR

Rev.	Revision	Date	Drawn	Checked
C	AS BUILT PLANS	FEB 10	MJB	

castleoak care partnerships

Castleoak Care Partnerships Limited
Raglan House, Greenwood Close, Cardiff Gate Business Park, Cardiff. CF23 8RD
T: 029 2054 5420 F: 029 2054 5421 www.castleoak.co.uk

Client BPHA

Project PROPOSED EXTRA CARE DEVELOPMENT

Location FARLEY HOUSE, WHIPPERLEY RING, LUTON

Title FLOOR PLANS

Scale	Date	Drawn	Checked
A1@1:200	AUG 07	CAP/MR	

Client no.	Job no.	Drawing no.	Revision
	A-529	11	C

Dimensions shall not be scaled & figured dimensions must be verified on site before work commences
This drawing is copyright © Carless & Adams Partnership (01628 665131)